


NORTH WEST ELEVATION  
SCALE: 1:100

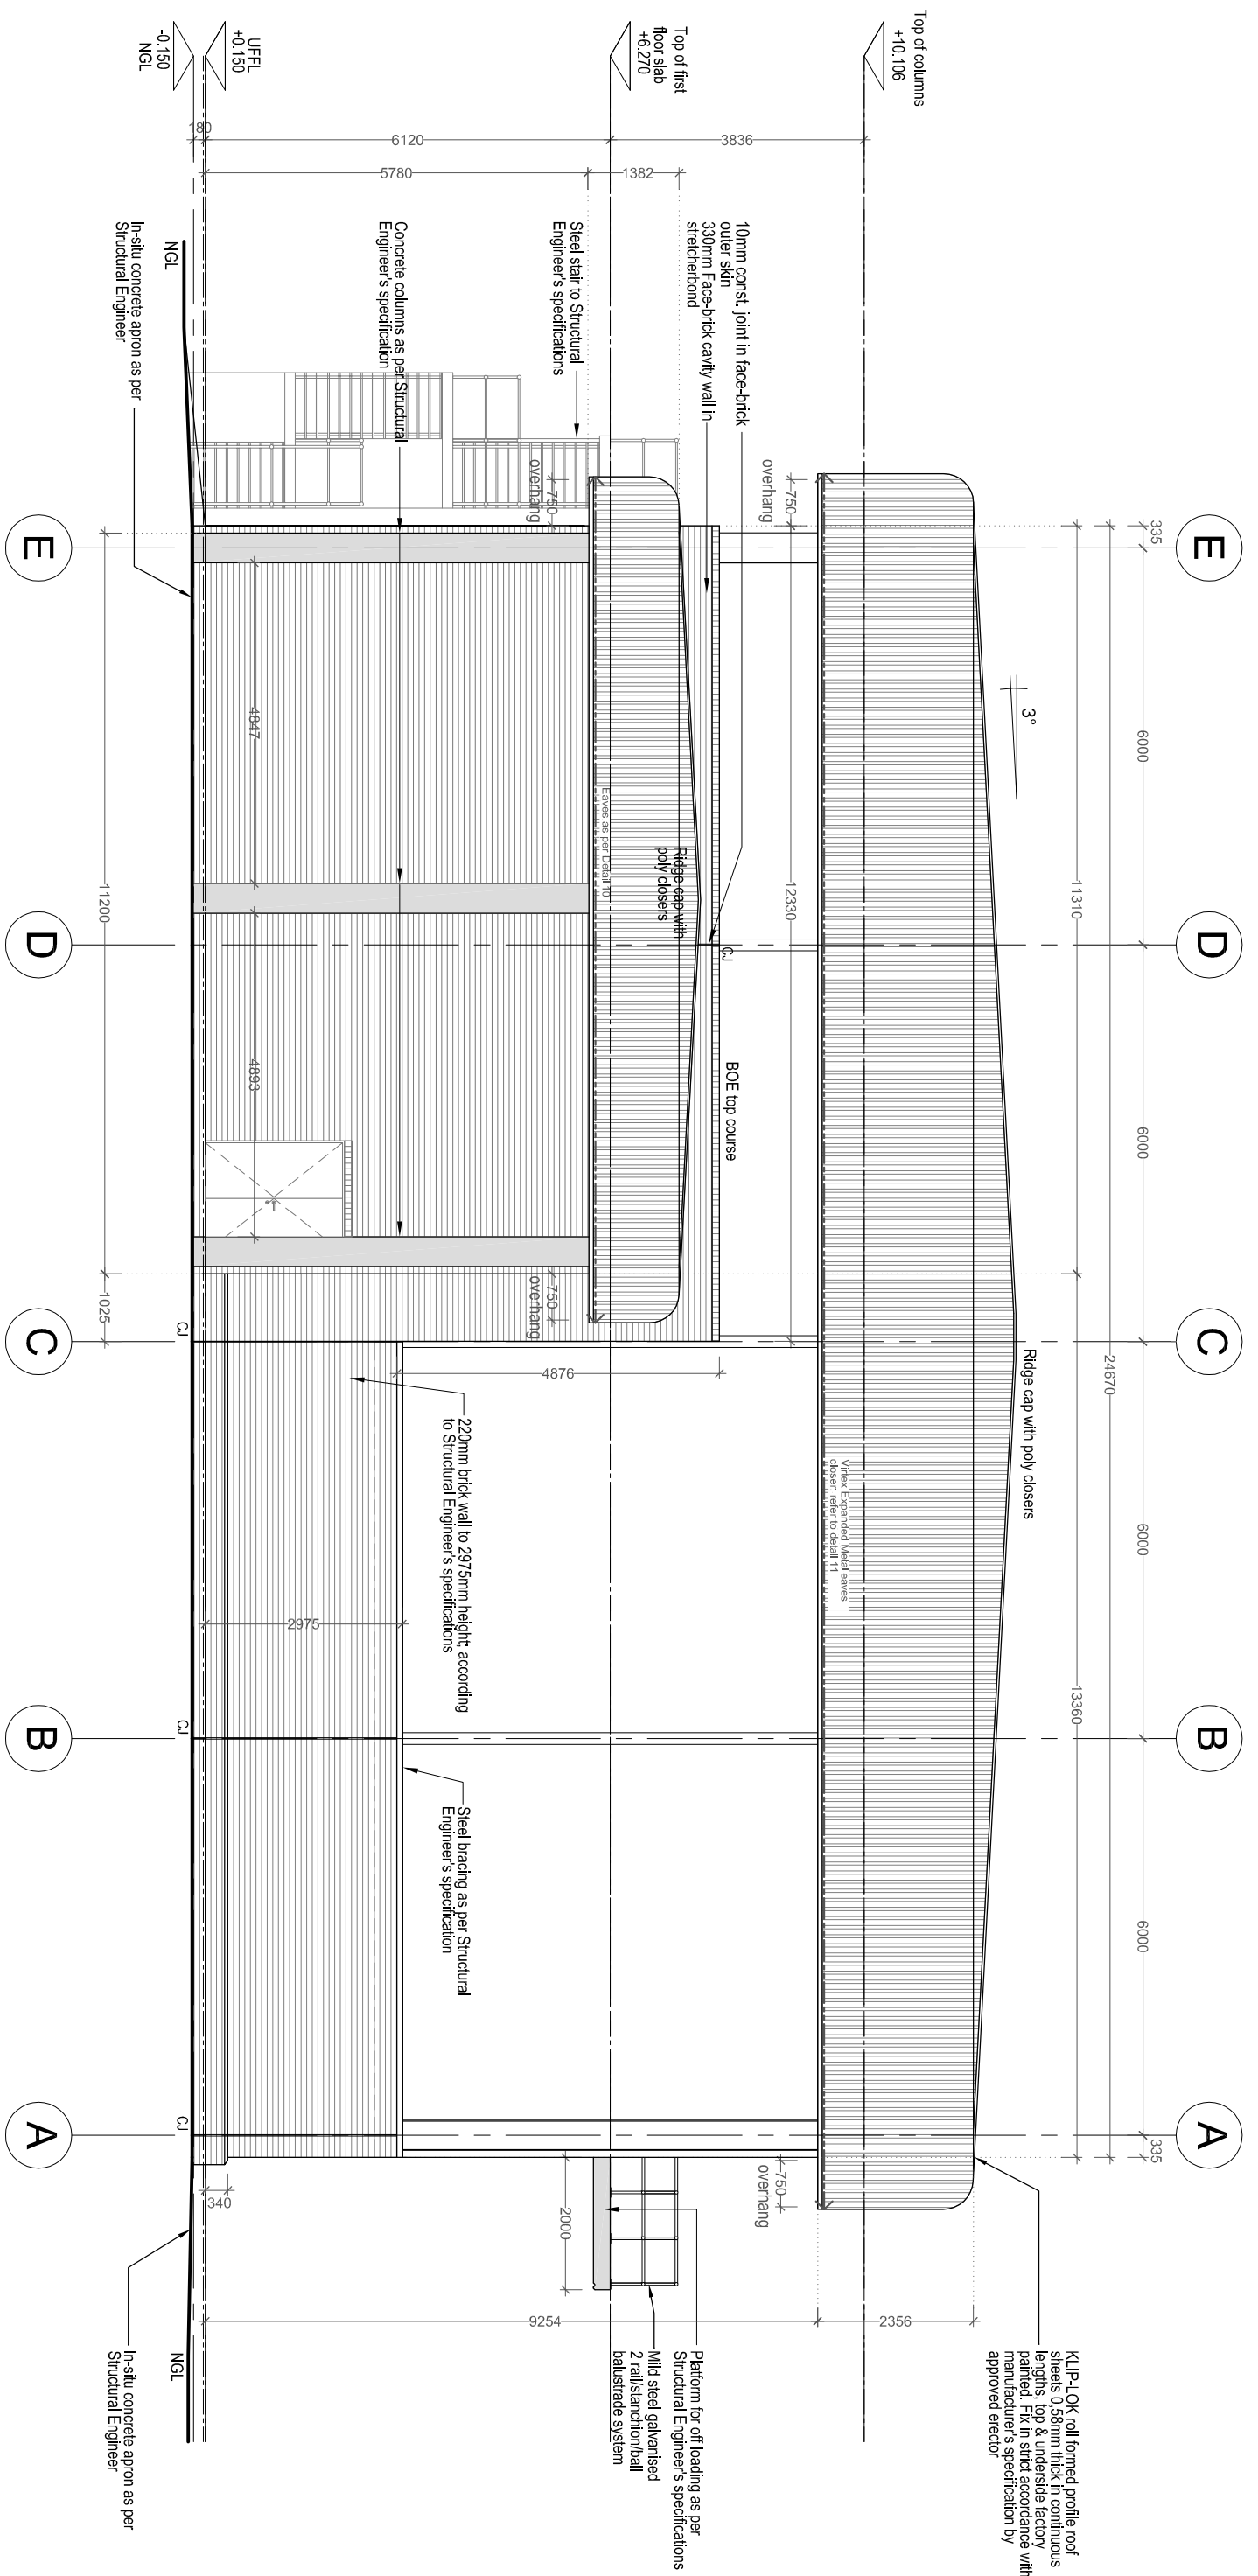

NORTH EAST ELEVATION  
SCALE: 1:100

[illegible]

AS BUILT

Copyright reserved in favour of the aforementioned architect.  
All dimensions are to be checked on site. Only figured dimensions are to be used.  
Any references to specialists work, items, finishes etc. are normally covered under preliminary annotation of the P.C.I. items. For the purposes of the contract, the architect is not responsible for the correctness of any contraindications must be settled beforehand with architect.  
This drawing is to read in conjunction with Structural, Civil, Electrical and Mechanical engineers drawings  
All materials to be paint finished as specified where supplied without factory finish  
Contractor to comply with SANS 10400 National Building Regulations and SANS 10137 National Building Regulations and SAGI (South African Glass Institute) regulations and SAGI (South African Glass Institute) .  
Safety glass doors must be marked with visible band.

| TABEL - DIMENSIONS OF GLASS |              |
|-----------------------------|--------------|
| Nominal thickness           | Maximum size |

**KKS STRUCTURAL CODE 4 0ULD**