


NORTH WEST ELEVATION
SCALE: 1:100

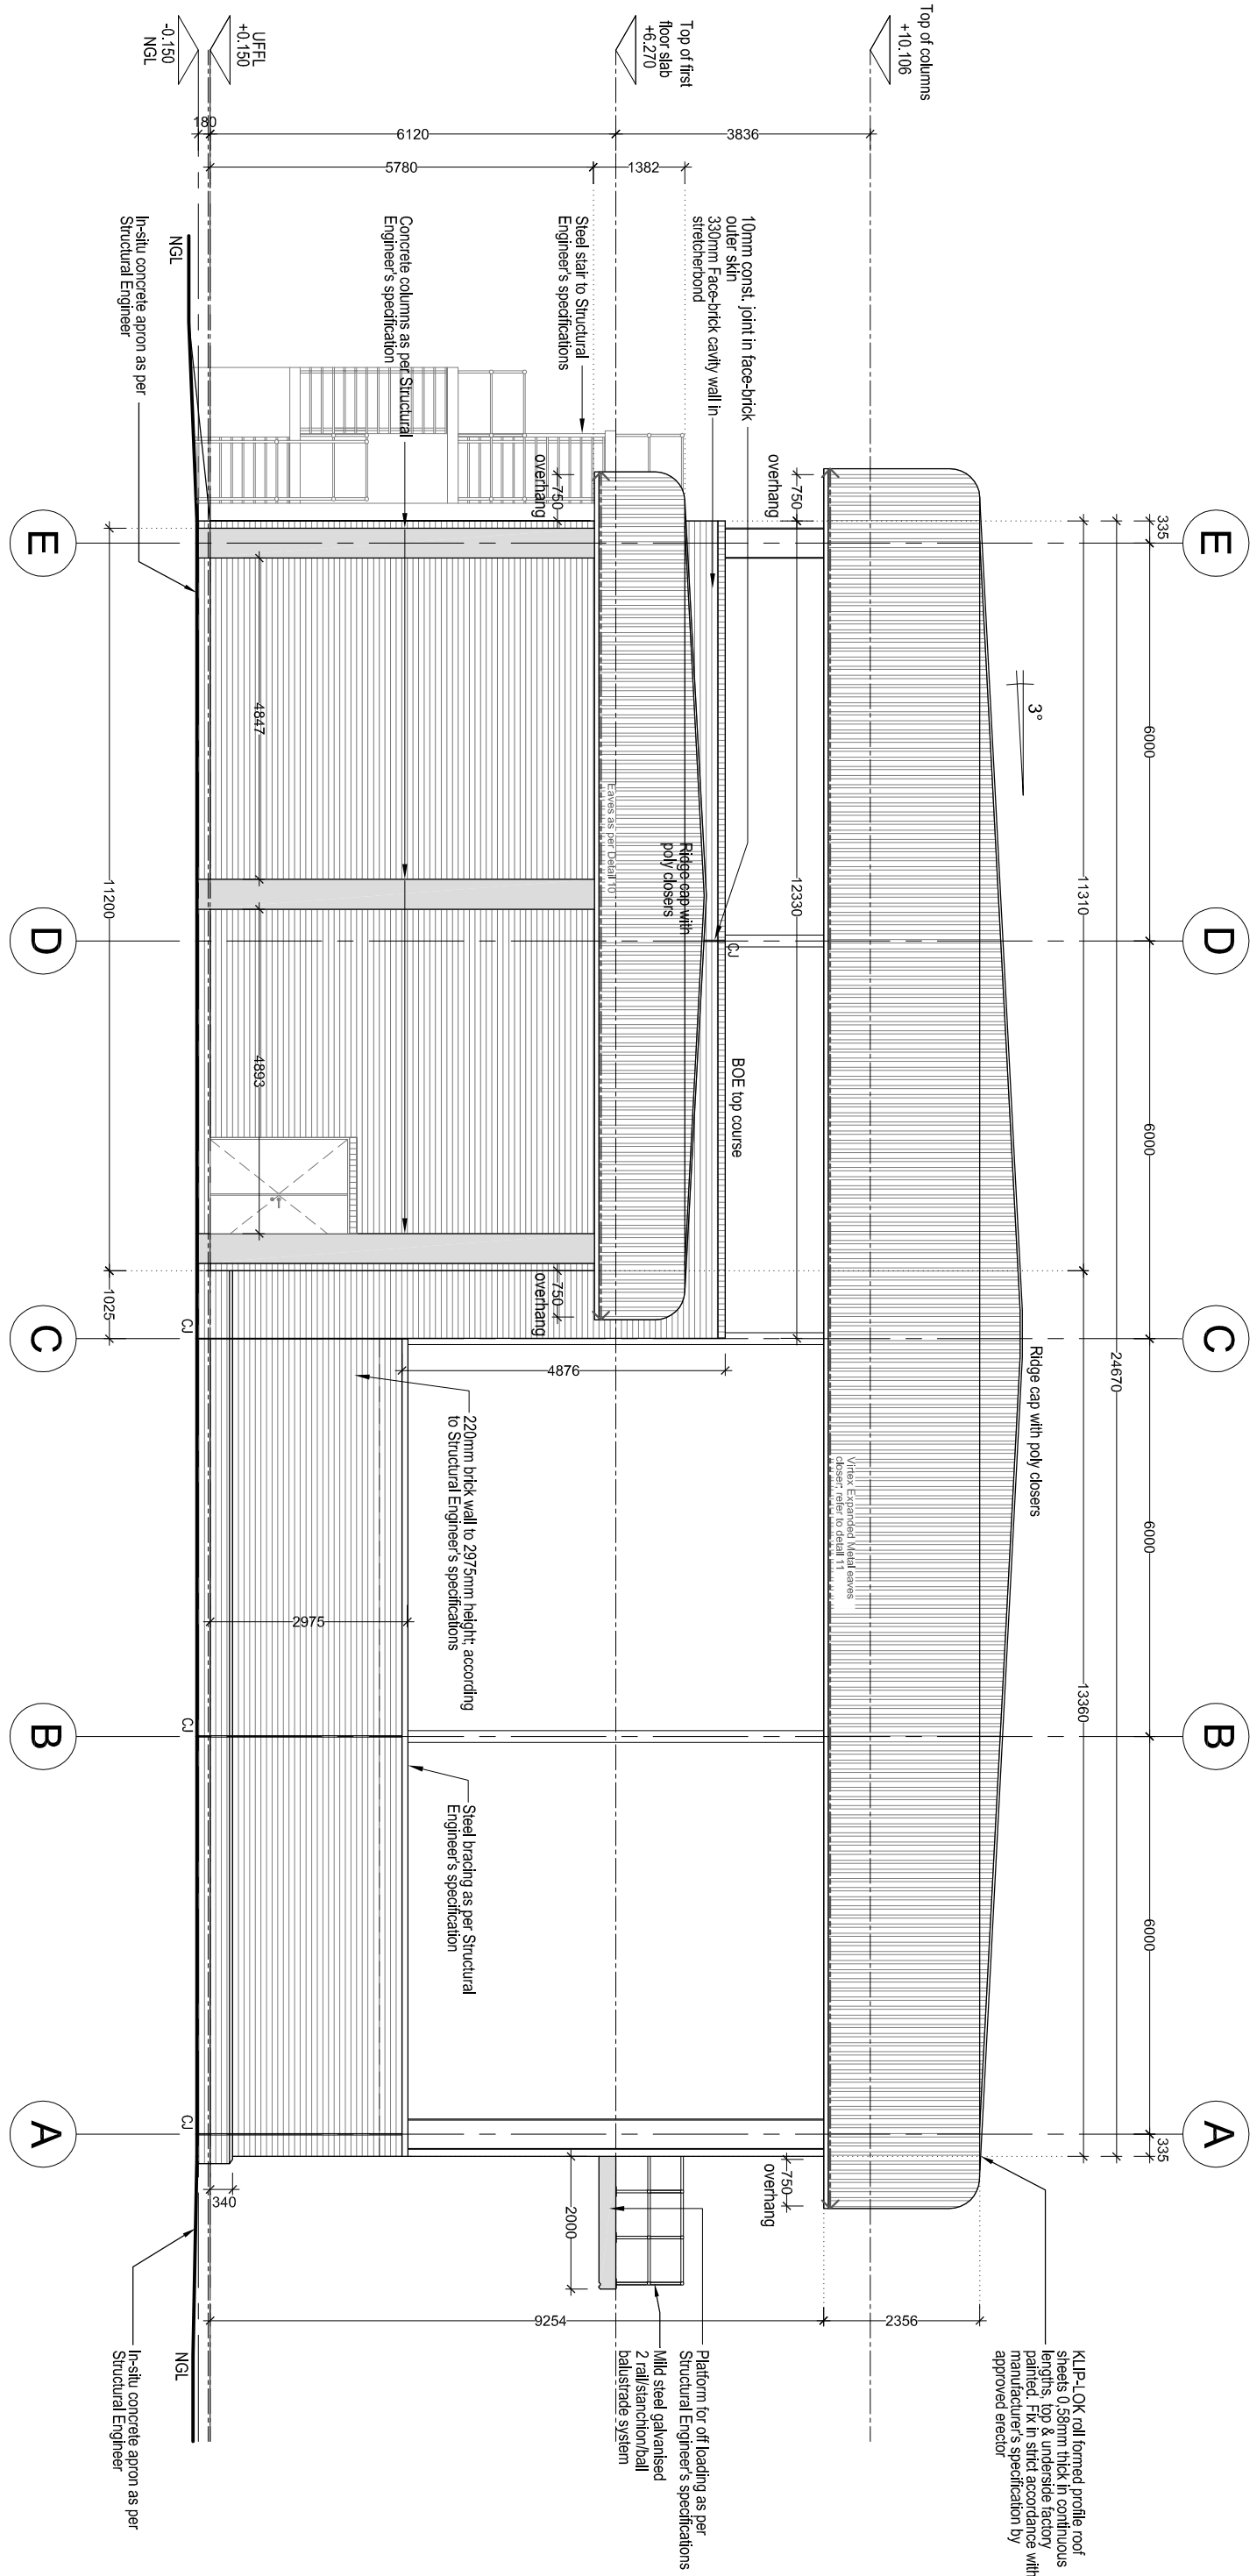

NORTH EAST ELEVATION
SCALE: 1:100

[illegible]

AS BUILT

Any references to specialist work, items, finishes etc., are normally covered under preliminary amounts or PC items. If not the contractor must still price these specialized work, items or finishes. Any contractors must be settled beforehand with architect.

This drawing to be read in conjunction with Structural, Civil,

Electrical and Mechanical Engineers drawings
All materials to be paint finished as specified where supplied

Building work to comply with SANS 10400 National Building without factory finish

building work to comply with SANS 10400 National Building Regulations

Glass installation to comply with SANS 10137, National Building Regulations and SAGI (South African Glass Institute)

Safety glass in doors must be marked with visible band.

TABEL - DIMENSIONS OF GLASS

Nominal thickness of glass, mm	Maximum size glass, meter
-----------------------------------	------------------------------

2	0.7E	1
---	------	---

	0.75	1.5	Designer:	W.M.D.
3				
4				

PrArch no: 969

11	12
----	----

[illegible]

SIZE	A1L
GRROUPE	