



SECTION A-A

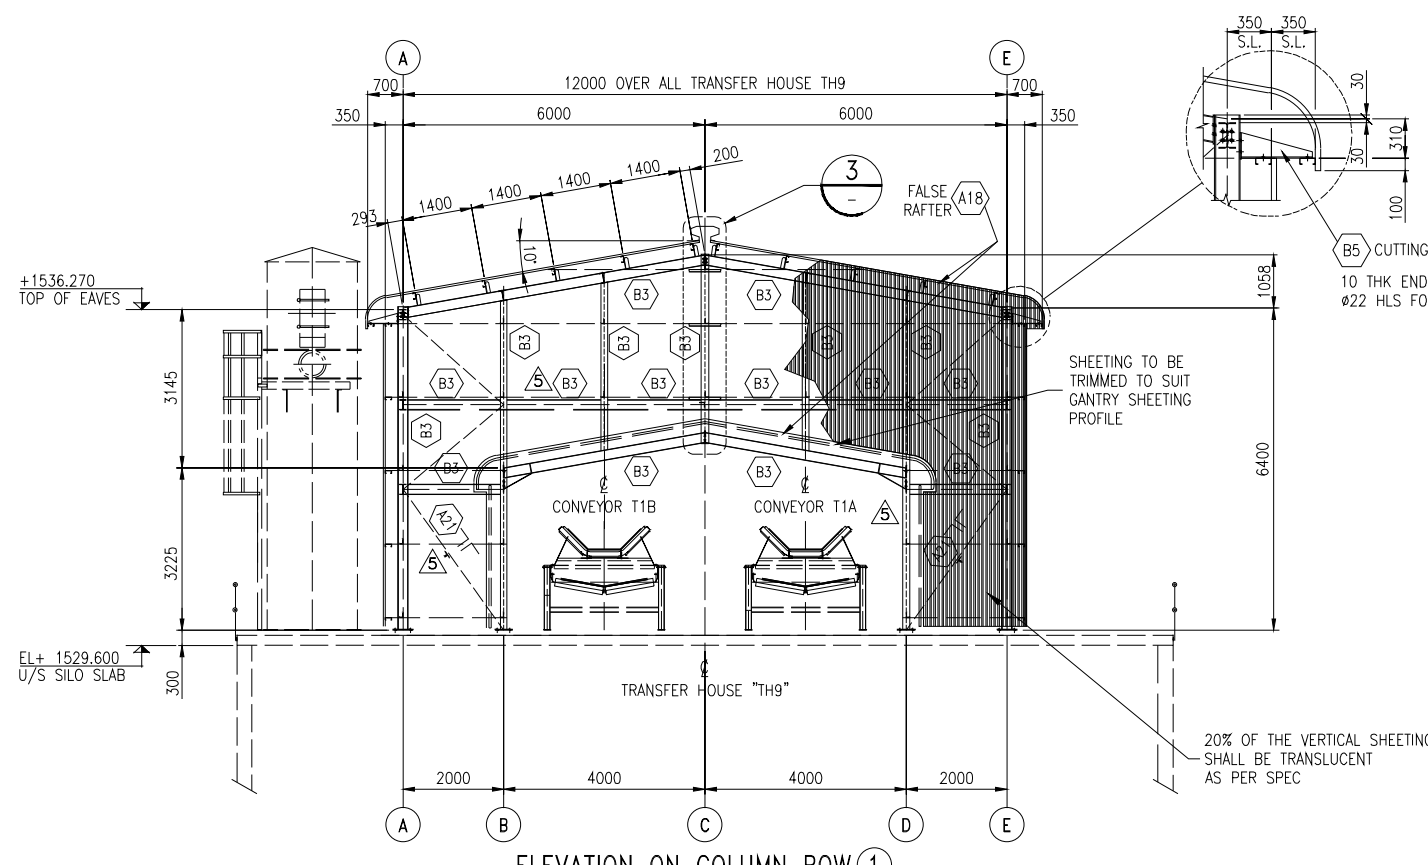


ELEVATION ON COLUMN ROW 1

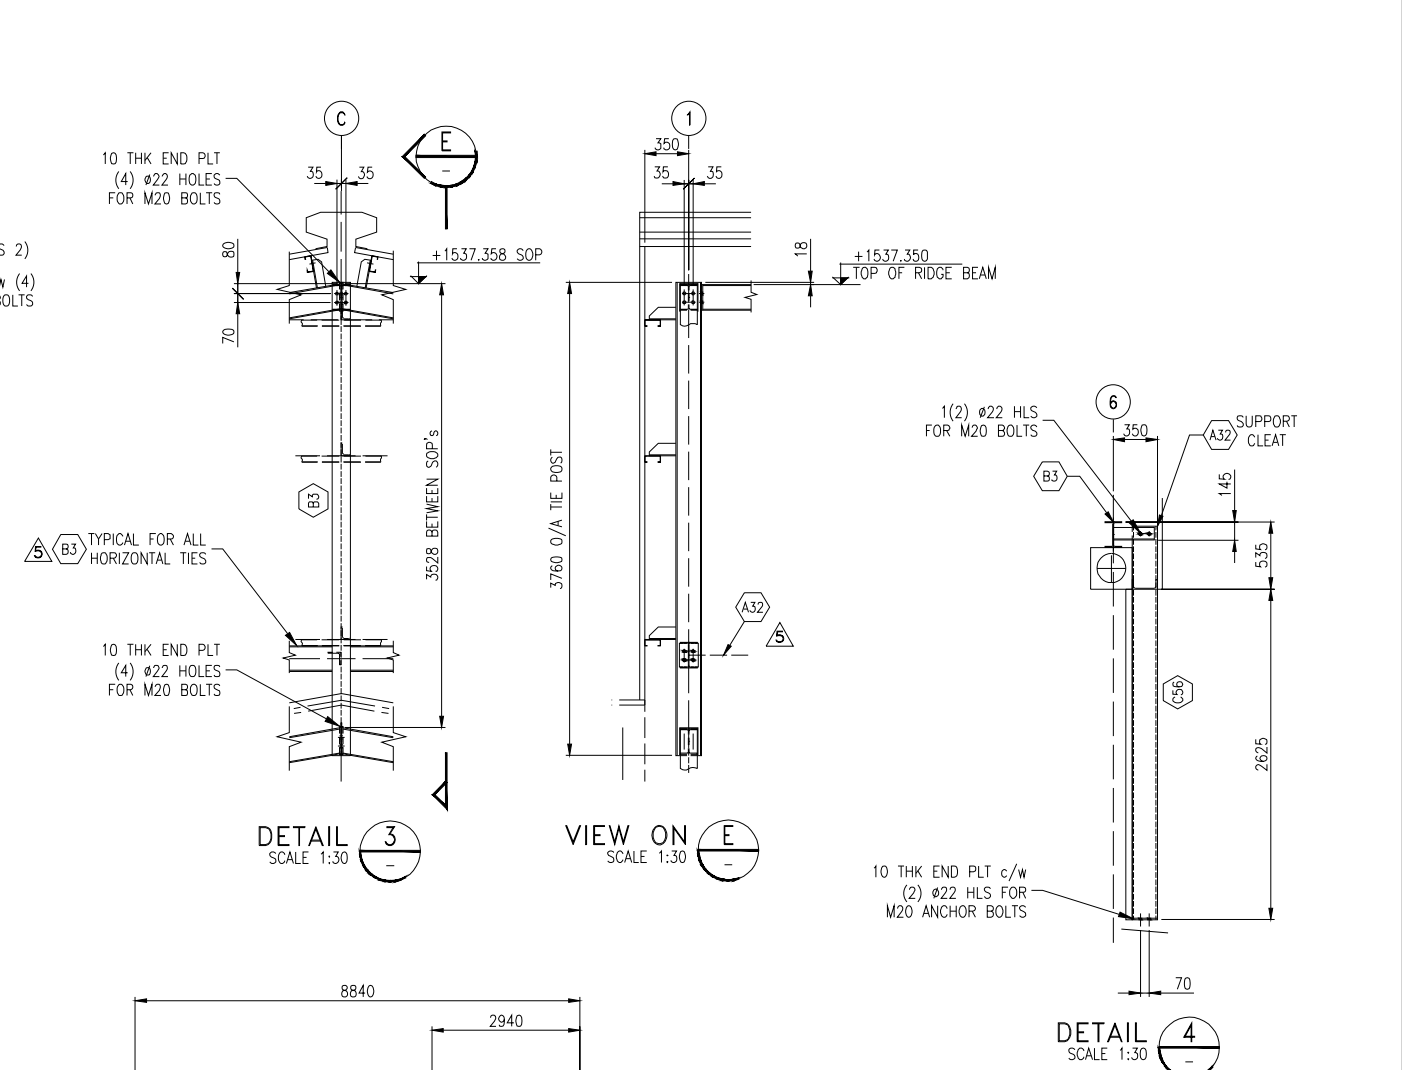


DETAIL 3

VIEW ON E


DETAIL 4

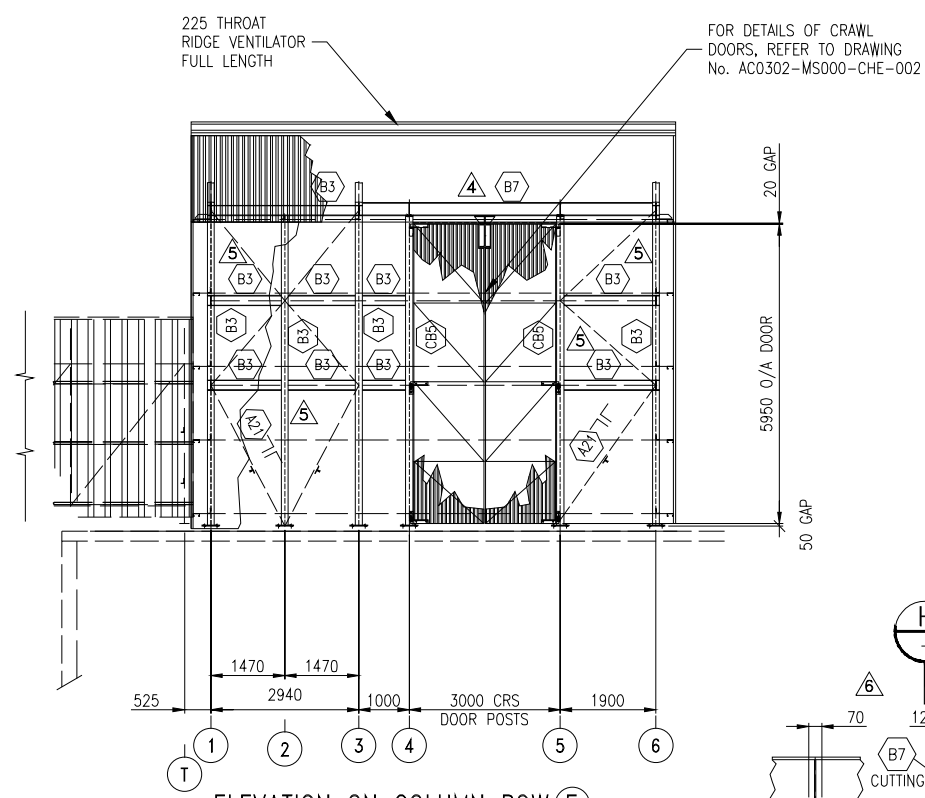

ELEVATION ON COLUMN ROW E

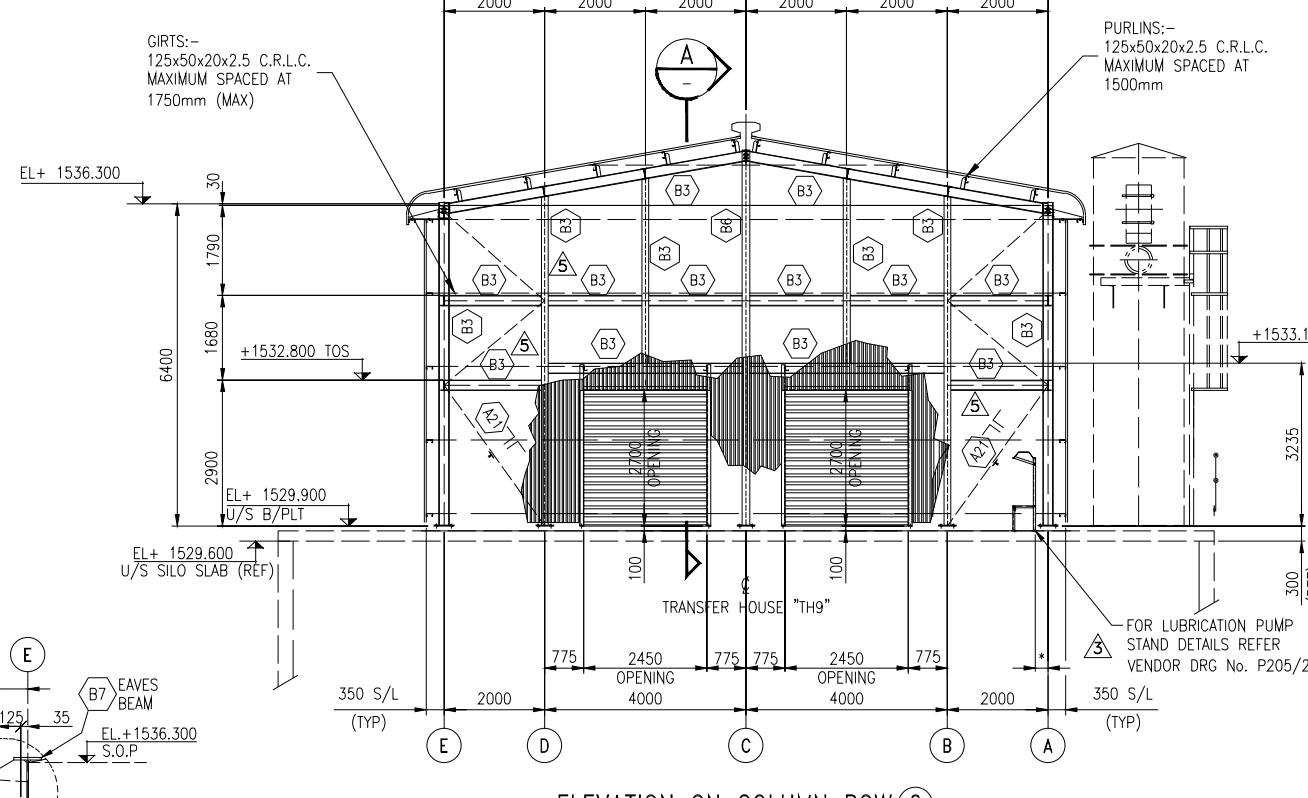


ELEVATION ON COLUMN ROW 6

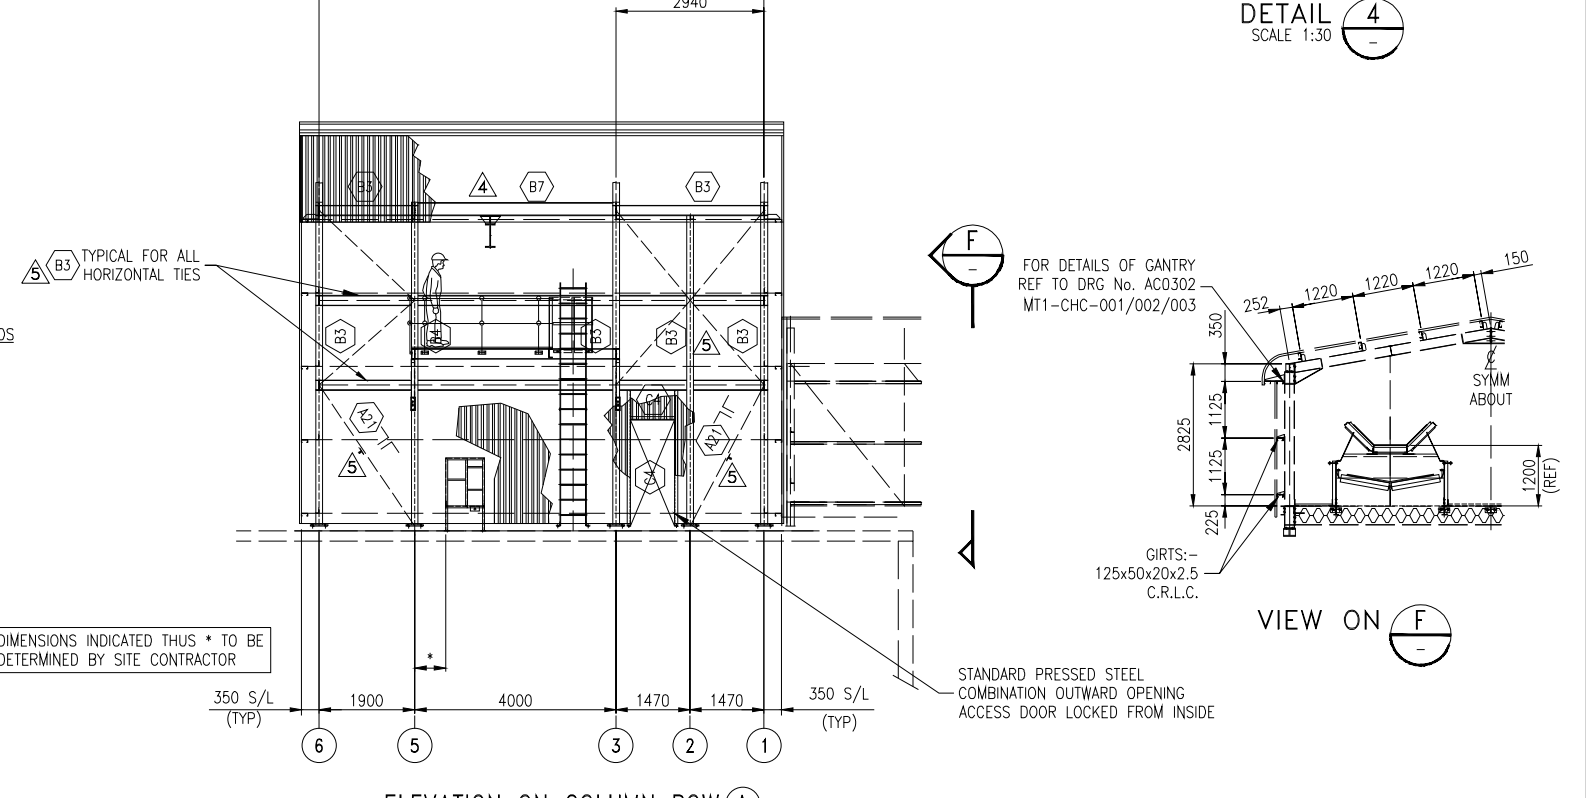

ELEVATION ON COLUMN ROW A


FOR ALL CRAWL BEAM DETAILS NOT SHOWN REFER TO DRAWING No. AC0302-MS000-CAB-000

CRAWL BEAM NOTE:-
S.W.L. 5000kg TO BE PAINTED IN BLACK LETTERS ON YELLOW BACKGROUND IN A SIZE THAT IS CLEARLY READABLE FROM FLOOR LEVEL

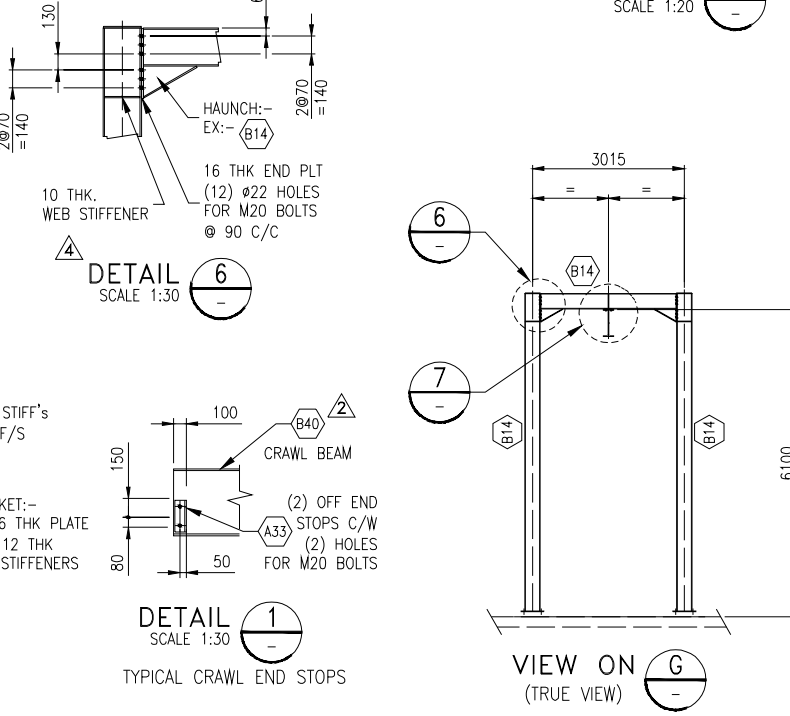


DETAIL 6

VIEW ON D

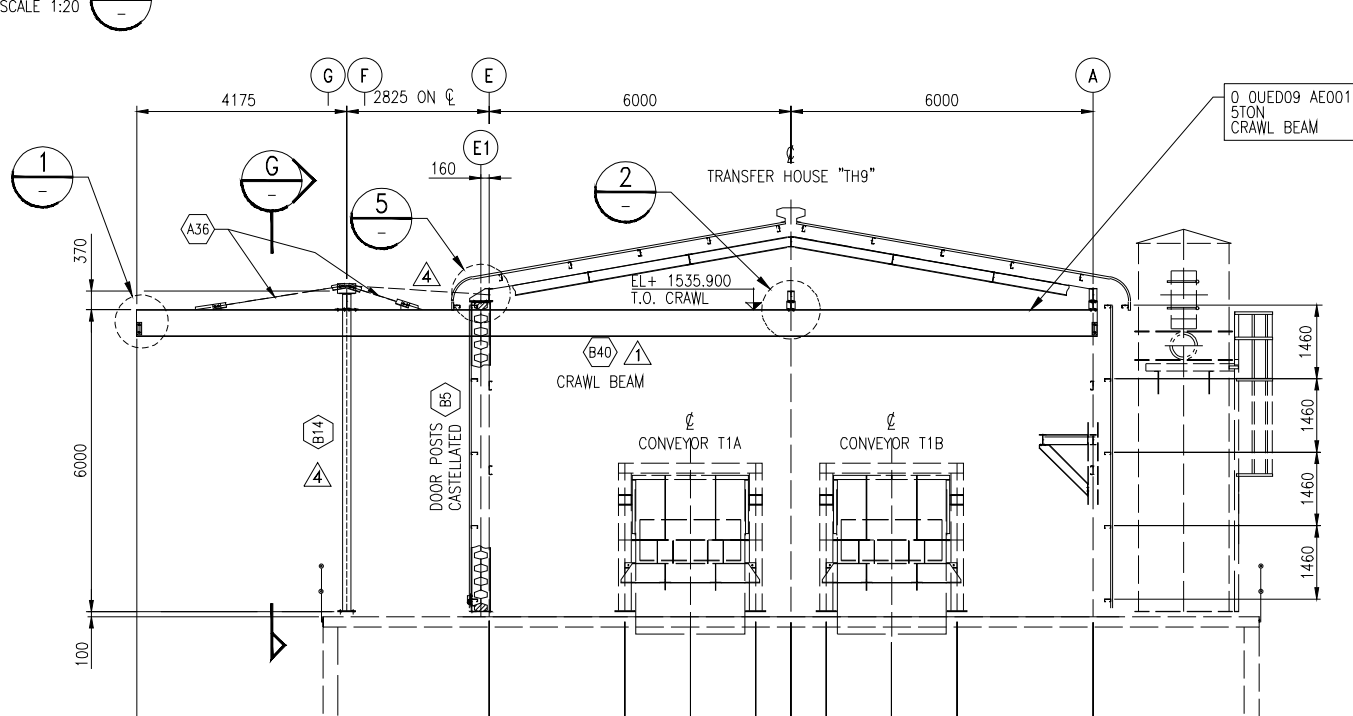

SECTION B-B

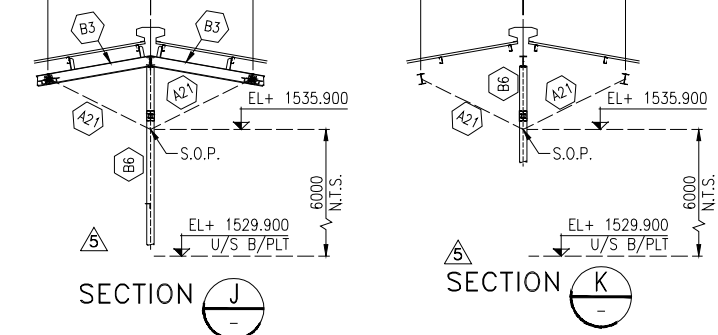

SECTION J

SECTION K


FOR GENERAL NOTES REFER TO DRAWING No MC000-WAA-001 FOR MEMBER SIZE LEGEND REFER TO DRAWING No MC000-WAA-002									
MT1	CFA	01/03	5	1/m	130x6 KICK PLATE	-	-	-	-
MT1	NGB	01/04	9.5	1/m	225 THROAT FULL LENGTH RIDGE VENTILATOR	-	-	-	-
MT1	NGB	01/03	47	m ²	TRANSLUCENT SHEETING AS PER SPEC	-	-	-	-
MT1	NGB	01/02	138	m ²	ROOF SHEETING AS PER SPEC	-	-	-	-
MT1	NGB	01/01	187	m ²	SIDE SHEETING AS PER SPEC	-	-	-	-
MT1	CGA	01/01	5	1/m	HANDRAILING	-	-	-	-
MT1	CEA	01/01	2	m ²	FLOORING	-	-	-	-
MT1	CHE	01/01	1		COMPLETE STRUCTURE STEELWORK	S355JR	12092		
MT1	CHE	01/02	1		SITE MODIFICATIONS	S355JR	1430		
REV	NO	DATE	DESCRIPTION	QUANTITY	DESCRIPTION	MATL	UNIT	TOTAL	
							MASS	MASS	
							kg	kg	
ORDERING SCHEDULE FOR SUPPLY TO THIS DRAWING									

FOR GENERAL NOTES REFER TO DRAWING No MC000-WAA-001 FOR MEMBER SIZE LEGEND REFER TO DRAWING No MC000-WAA-002									
1	10/02/2012	ISSUED FOR CRAWL BEAM KISS CODE ADDED	TS	NM	LS				
2	10/02/2012	AS-BUILT	TS	NM	LS				
3	10/02/2012	CONNECTIONS UPDATED TO SAT REMEDIAL DESIGN	TS	NM	LS				
4	10/02/2012	AS PER REMEDIAL DESIGN	TS	NM	LS				
5	10/02/2012	NEW 'BT' BEAM ADDED TO GRID LINE 'A' & 'F'	TS	NM	LS				
6	10/02/2012	CRAWL BEAM SUPPORT FRAME WAS NOT SHOWN	TS	NM	LS				
7	10/02/2012	LUB. PUMP STAND LOCATION INDICATED	R.M.	C.N.	G.G.				
8	10/02/2012	CRAWL BEAM MEMBER CORRECTED	C.N.	C.G.S.	G.G.				
9	10/02/2012	RODS FORWARDED TO CRAWL BEAM SIZE REVED	W.S.	C.G.S.	R.M.				
10	10/02/2012	ISSUED FOR CONSTRUCTION	LTPL	LEP	S.C.				
REFERENCE DRAWINGS									
ESKOM - KUSILE POWER STATION COAL STOCKYARD CONVEYOR T1A & T1B - 1800 BELT TRANSFER HOUSE TH9 - ELEVATIONS									
AC0302-MT1-CHE-001									
0.90/38485									

TENOVA
AS BUILT DRAWING

REV	DATE	DESCRIPTION	BY	CHKD	APPD	DATE	NAME
1	10/02/2012	ISSUED FOR CRAWL BEAM KISS CODE ADDED	TS	NM	LS		
2	10/02/2012	AS-BUILT	TS	NM	LS		
3	10/02/2012	CONNECTIONS UPDATED TO SAT REMEDIAL DESIGN	TS	NM	LS		
4	10/02/2012	AS PER REMEDIAL DESIGN	TS	NM	LS		
5	10/02/2012	NEW 'BT' BEAM ADDED TO GRID LINE 'A' & 'F'	TS	NM	LS		
6	10/02/2012	CRAWL BEAM SUPPORT FRAME WAS NOT SHOWN	TS	NM	LS		
7	10/02/2012	LUB. PUMP STAND LOCATION INDICATED	R.M.	C.N.	G.G.		
8	10/02/2012	CRAWL BEAM MEMBER CORRECTED	C.N.	C.G.S.	G.G.		
9	10/02/2012	RODS FORWARDED TO CRAWL BEAM SIZE REVED	W.S.	C.G.S.	R.M.		
10	10/02/2012	ISSUED FOR CONSTRUCTION	LTPL	LEP	S.C.		

REFERENCE	DRG. NUMBER	TITLE
AC0302-MT1-CHE-002	TRANSFER HOUSE TH9 - PLANS	
AC0302-MT1-FAA-001	MECHANICAL ARRANGEMENT	

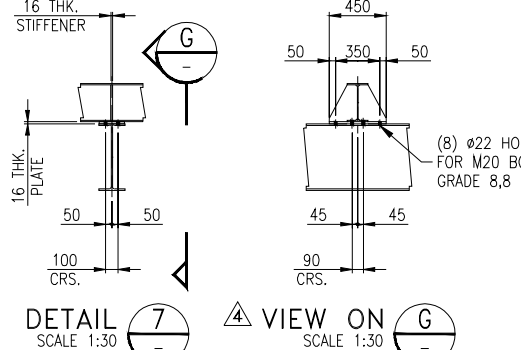

DETAIL 7

VIEW ON G